

NATURAL SURFACE LEVEL	691.000	688.000
INVERT LEVEL TUNNEL (FINISHED)	465.000	
PARTIAL LENGTH	5000	19500
CUMULATIVE LENGTH	24500	19500
SLOPE		0%

SECTION C
(TYPICAL SECTION
THROUGH 6" OF VERTICAL
PRESSURE SHAFT)

NATURAL SURFACE LEVEL	662.000	668.000	686.000	720.000	731.000	724.000	695.000	685.000
TUNNEL INVERT LEVEL (FINISHED)	465.000	465.000	465.000	465.000	465.000	465.000	465.000	465.000
PARTIAL LENGTH	8000	40000	40000	20000 40000	20000	40000	40000	8000
CUMULATIVE LENGTH	0.00	8000	48000	88000	128000	168000	208000	216000
SLOPE	0%							

LONGITUDINAL SECTION (B)


CO-ORDINATES: (ADIT TO PRESSURE SHAFT TOP)		
POINTS	NORTHING IN METRE	EASTING IN METRE
AHR75/ APST-1	31619.015	32188.769
APST-2	31624.819	32201.509
APST-3	31672.791	32306.821
APST-4	31724.386	32335.721
APST-C1	31718.293	32286.093
APST-5	31735.086	32334.407
APST-6	31747.493	32332.884
APST-7	31734.331	32225.689
APST-8	31735.306	32233.629
APST-9	31740.180	32273.331
APST-10	31745.055	32313.033
APST-11	31749.93	32352.734
APST-12	31754.805	32392.436
APST-13	31759.679	32432.138
APST-14	31760.654	32440.079
VPST-1	31754.660	32231.252
VPST-2	31759.535	32270.954
VPST-3	31764.410	32310.656
VPST-4	31769.285	32350.358
VPST-5	31774.159	32390.060
VPST-6	31779.034	32429.762

REFERENCE DRAWINGS:-

1. NHDB-1AC4-41-DD-0001.
2. NHDB-3BC4-41-DD-0001.
3. NHDB-3BC4-41-DD-1002 TO 1004.

NOTES:-

1. सभी माप मिलिमीटर में, ग्रिड तथा ऊचाई मीटर में दिए गए हैं।
ALL DIMENSIONS ARE IN MILLIMETRE, GRIDS AND ELEVATIONS ARE IN METRE
2. GRIDS HAVE BEEN REPRODUCED FROM S.O.I. TOPO SHEET. THE ACCURACY OF THE GRID SYSTEM SHALL BE ESTABLISHED WITH EXISTING S.O.I BENCH MARK AT SITE BEFORE ADOPTING COORDINATES.
3. THE VALUES OF NSL ARE BASED ON SURVEY PROVIDED BY PROJECT VIDE IOM NO. NH\DI\BANG\DM & INTAKE CONSTRUCTION\2024\5 DATED 19.03.2024. SAME SHALL BE VERIFIED WITH EXISTING BENCH MARKS AT SITE.
4. THE LEVELS SHOWN CORRESPONDS TO THE FINISHED SURFACES/LINES. FOR LEVELS OF EXCAVATION REFER EXCAVATION DRAWING.
5. FOR EXCAVATION AND ROCK SUPPORT DETAILS REFER DRAWING NO. NHDB-3BC4-41-DD-1002 TO 1004.
6. FOR EXCAVATION AND ROCK SUPPORT AT ADITS JUNCTION (BIFURCATION/ INTERSECTION), REFER SEPARATE DRAWING.
7. THIS DRAWING SHALL BE READ IN CONJUNCTION WITH DRG. NO.NHDB-1AC4-41-DD-0001 & NHDB-3BC4-41-DD-0001.
8. ALIGNMENT OF ADIT TO PRESSURE SHAFT TOP MODIFIED AS PER HM REQUIREMENT.
9. THIS DRAWING HAS BEEN REVISED AS PER AS BUILT DATA OF ADIT TO HRT RECEIVED FROM PROJECT VIDE EIOM - NH\DI\BANG\Power House-Civil\2025\ 110 DATED-24.07.25.

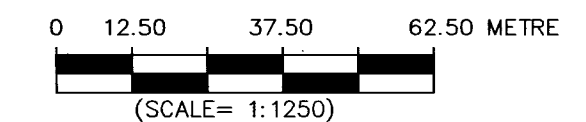

A Navratna Company

एन एच पी सी लिमिटेड
(भारत सरकार का एक नवरात्रि उद्यम)
NHPC Limited
(A GOVT. OF INDIA NAVRATNA ENTERPRISE)

दिबांग बहुउद्देशीय परियोजना DIBANG MULTIPURPOSE PROJECT

PRESSURE SHAFT
 ADIT TO PRESSURE SHAFT TOP
 SETTING OUT PLAN AND LONGITUDINAL SECTION

